


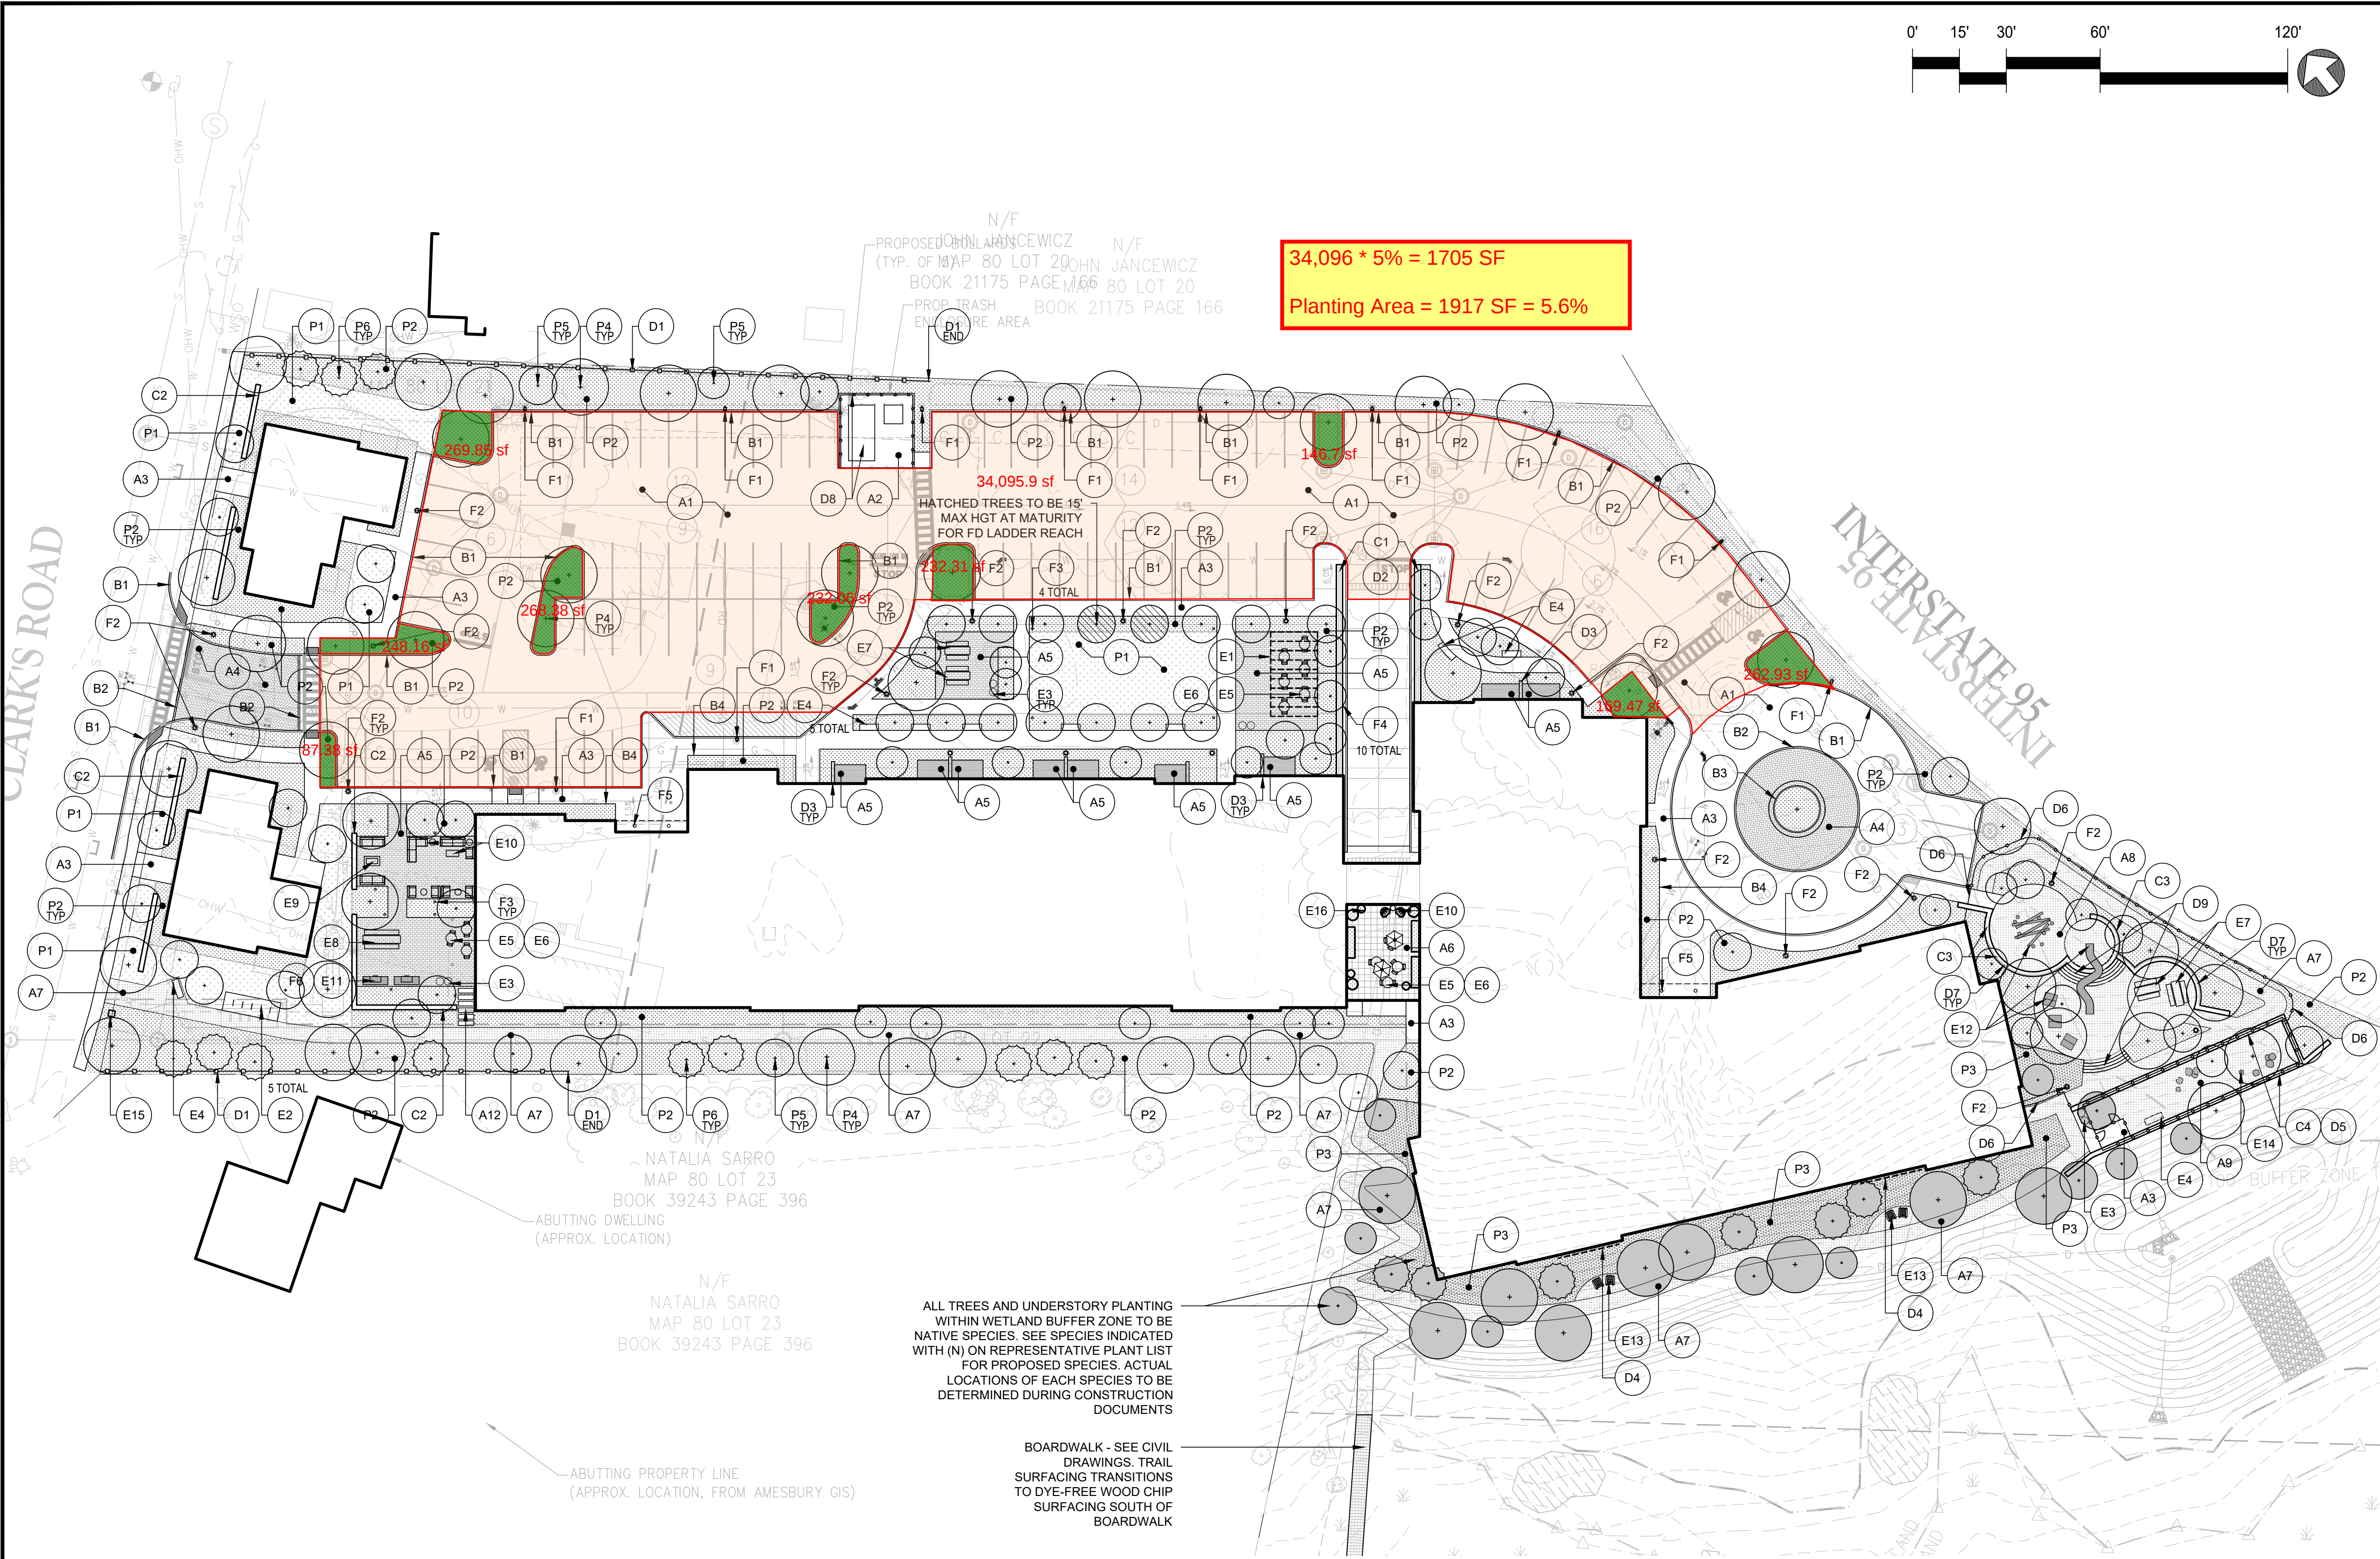

MATERIALS LEGEND

TAG	DESCRIPTION	DETAIL
PAVING		
A1	BITUMINOUS CONCRETE PAVING - VEHICULAR - SEE CIVIL DRAWINGS	
A2	POURED IN PLACE CONCRETE PAVING - VEHICULAR - SEE CIVIL DRAWINGS	
A3	POURED IN PLACE CONCRETE PAVING - PEDESTRIAN - SEE CIVIL DRAWINGS	
A4	PRECAST CONCRETE UNIT PAVERS - VEHICULAR	
A5	PRECAST CONCRETE UNIT PAVERS - PEDESTRIAN	
A6	PRECAST CONCRETE UNIT PAVERS ON PEDESTAL SYSTEM	
A7	STABILIZED STONEDUST TRAIL SURFACING	
A8	ENGINEERED WOOD FIBER PLAYGROUND SURFACING	
A9	RICE STONE SURFACING AT PET RELIEF AREA	
A10	ACCESSIBLE CURB RAMP - SEE CIVIL DRAWINGS	
A11	DETECTABLE WARNING PANEL - SEE CIVIL DRAWINGS	
A12	FLUSH STONE STEPPERS	
CURBS		
B1	ROADWAY/PARKING LOT CURB - SEE CIVIL DRAWINGS	
B2	6" WIDTH FLUSH GRANITE CURB/EDGE	
B3	4" WIDTH GRANITE LANDSCAPE/PLANTER CURB	
B4	METAL PLANTER CURB	
WALLS		
C1	CONCRETE GARAGE RAMP RETAINING WALL	
C2	FIELDSTONE LANDSCAPE WALL	
C3	CONCRETE RETAINING WALL AT NATURE PLAY AREA	
C4	CONCRETE RETAINING WALL AT DOG RUN	
STAIRS, RAILS & FENCES		
D1	6 FT HEIGHT WOOD SLAT SCREEN FENCE AT PROPERTY LINE	
D2	DECORATIVE SCREEN FENCE AT GARAGE RAMP RETAINING WALLS	
D3	6' HEIGHT WOOD AND METAL PATIO PRIVACY SCREENS	
D4	DECORATIVE SCREEN FENCE AT BUILDING FOUNDATION AT SEATING NODES	
D5	4' HEIGHT BLACK VINYL COATED CHAINLINK PERIMETER FENCE AND GATE VESTIBULE AT PET RELIEF AREA	
D6	4' HEIGHT BLACK VINYL COATED CHAINLINK PERIMETER FENCE AND GATES AT NATURE PLAY AREA	
D7	42" HEIGHT GUARDRAIL AT RETAINING WALLS WITHIN NATURE PLAY AREA	
D8	TRASH ENCLOSURE FENCE AND GATE	
D9	TIMBER STEPS AT PLAY AREA	
FURNISHINGS		
E1	WOOD AND METAL PERGOLA STRUCTURE	
E2	BIKE RACK	
E3	TRASH & RECYCLING RECEPTACLES (PAIRS) - ASSUME QTY: 4 PAIRS	
E4	WOOD AND METAL FREESTANDING BENCH	
E5	CAFE TABLE - 30" DIA. ROUND	
E6	CAFE CHAIRS	
E7	WOOD AND METAL PICNIC STYLE TABLE AND BENCHES	
E8	WOOD AND METAL LARGE COMMUNAL TABLE AND BENCHES	
E9	FIRE PIT	
E10	LOUNGE STYLE FURNITURE - ACTUAL TYPE AND LAYOUT TBD	
E11	OUTDOOR GRILLING STATIONS, ASSUME QTY: 2	
E12	NATURE PLAY AREA - ACTUAL COMPONENTS AND LAYOUT TBD	
E13	ADIRONDACK CHAIRS AT SEATING NODES	
E14	BOULDERS IN DOG RUN, ASSUME QTY: 5	
E15	WAYFINDING SIGNAGE AT TRAIL HEAD	
E16	FREESTANDING PLANTERS - ACTUAL TYPE AND LAYOUT TBD	

PLANTING	
P1	SEEDED LAWN
P2	PLANTING BED
P3	BUFFER ZONE PLANTING BED - NATIVE SPECIES ONLY. SEE PLANT SPECIES NOTED WITH (N) IN REPRESENTATIVE PLANT LIST
P4	DECIDUOUS SHADE TREE - 4" CALIPER. SEE TREE SPECIES NOTED WITH (N) IN REPRESENTATIVE PLANT LIST FOR TREES WITHIN BUFFER ZONE
P5	ORNAMENTAL TREE - 2.5" CALIPER. SEE TREE SPECIES NOTED WITH (N) IN REPRESENTATIVE PLANT LIST FOR TREES WITHIN BUFFER ZONE
P6	EVERGREEN TREE - 10'-12' HGT. SEE TREE SPECIES NOTED WITH (N) IN REPRESENTATIVE PLANT LIST FOR TREES WITHIN BUFFER ZONE
UTILITIES	
H1	EXISTING UTILITY POLE TO REMAIN
H2	NEW FIRE HYDRANT - SEE CIVIL DRAWINGS

LIGHTING	
F1	PARKING LOT POST TOP LIGHT - 18' HGT
F2	PEDESTRIAN POST TOP LIGHT - 12' HGT
F3	BOLLARD LIGHT
F4	PARKING GARAGE RAMP WALL MOUNTED LIGHT FIXTURES
F5	BUILDING MOUNTED ENTRY LIGHTING
F6	TASK LIGHT AT GRILL STATION

PLAN SET ISSUE TITLE

THIS DOCUMENT IS RELEASED
TEMPORARILY FOR PROGRESS REVIEW ONLY.
IT IS NOT INTENDED FOR BIDDING OR
CONSTRUCTION PURPOSES.

29 Clarks
Road

MINCO

Amesbury, MA

L1.1 LANDSCAPE MATERIALS PLAN

SCALE: AS NOTED