


Joseph F Oshaldston
28 Lake Attitash Road
Amesbury, MA
01913

Our dock
28 Lake Attitash rd

seasonal dock
late April to
late October

AS-BUILT

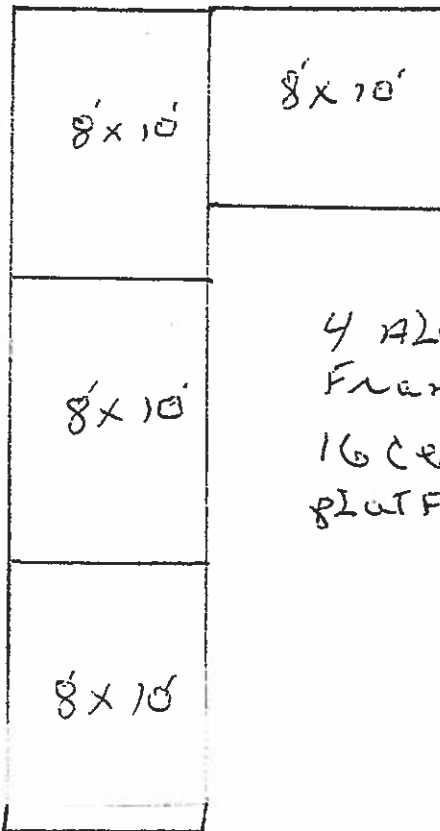

4 Aluminum
Frames
16 Cedar
Platform Logs

proposed
6/10

5' Rock wall

5' Rock wall

