

LOCUS PLAN

ZONING

CENTRAL BUSINESS DISTRICT
MIN. FRONTAGE: 50 FT.
MIN. AREA: 5000 S.F.
MIN. YARDS:

NOTE: EXISTING BUILDING PREDATES THE ZONING ORDINANCE.

ASSESSORS MAP NO. 7, PARCEL 20

SITE PLAN OF LAND
FIFTY -- SEVEN
MAIN PLACE CONDOMINIUM
IN
AMESBURY, MASS.
FOR
MERIDIAN REALTY TRUST

REVISION: 3-9-87 SEE EASEMENT NOTE


SCALE: 1" = 10'

FEBRUARY 27, 1987

0 10 20 30 40 F

SHEET 1 OF 7

86236

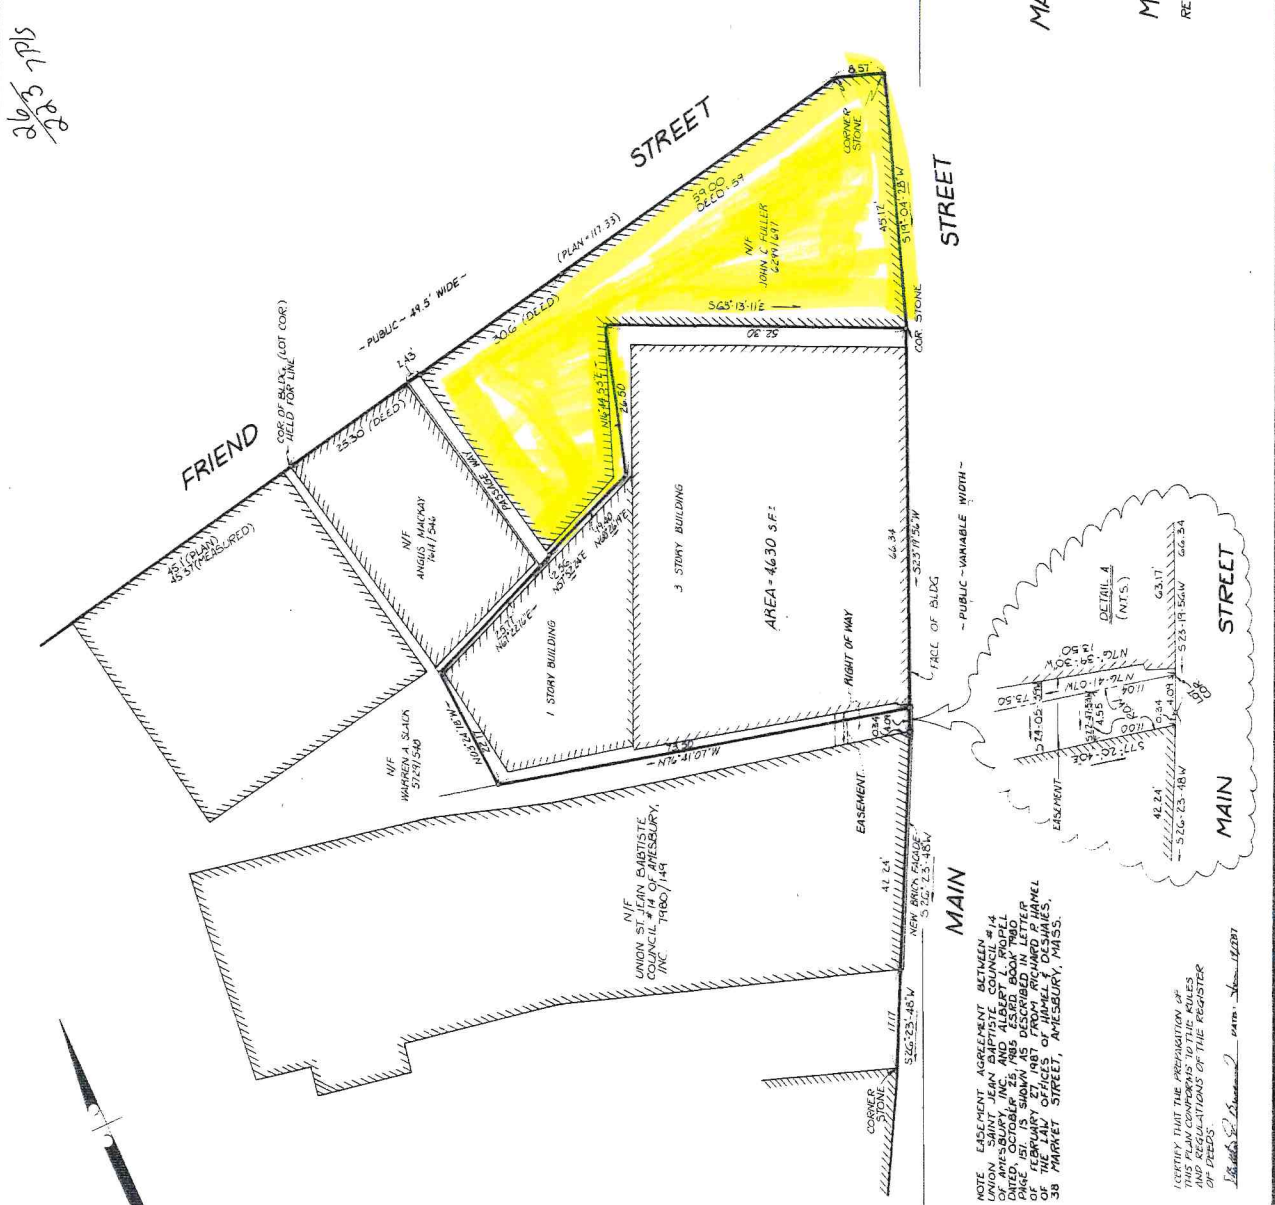

DEED REFERENCE:

OWNER - MERIDIAN REALTY TRUST
DATED, OCT. 15, 1986
BOOK '8569 PAGE 583

I CERTIFY:

THAT THE PREPARATION OF THIS PLAN CONFORMS
TO THE RULES AND REGULATIONS OF THE
REGISTER OF DEEDS.

2. THAT THIS PLAN FULLY AND ACCURATELY DEPICTS THE LAYOUT, UNIT NUMBERS, AND DIMENSIONS OF THE UNITS AS BUILT AS OF 3-9-87

THE PROPERTY LINES SHOWN ARE THE LINES
DIVIDING EXISTING OWNERSHIP⁵ AND THE

LINES OF STREETS AND WAYS SHOWN ARE
 THOSE OF PUBLIC OR PRIVATE STREETS OR
 WAYS ALREADY ESTABLISHED AND NO NEW
 LINES OR DIVISIONS OF EXISTING OWNERSHIP
 OR FOR NEW WAYS ARE SHOWN.

CHAPTER 380 ACTS OF 1966

THIS SURVEY AND PLAN WERE PREPARED IN ACCORDANCE WITH THE PROCEDURAL AND TECHNICAL STANDARDS FOR THE

AND TECHNICAL STANDARDS FOR THE
PRACTICE OF LAND SURVEYING IN THE
COMMONWEALTH OF MASSACHUSETTS



PLS
DATE 3-17-87
David E. ...

PLAN NO 06236

WIC CAMMETT ENGINEERING INC

W.C. CANIMETTI ENGINEERING, INC.
297 ELM STREET ~ AMESBURY, MASS.

Abstract