


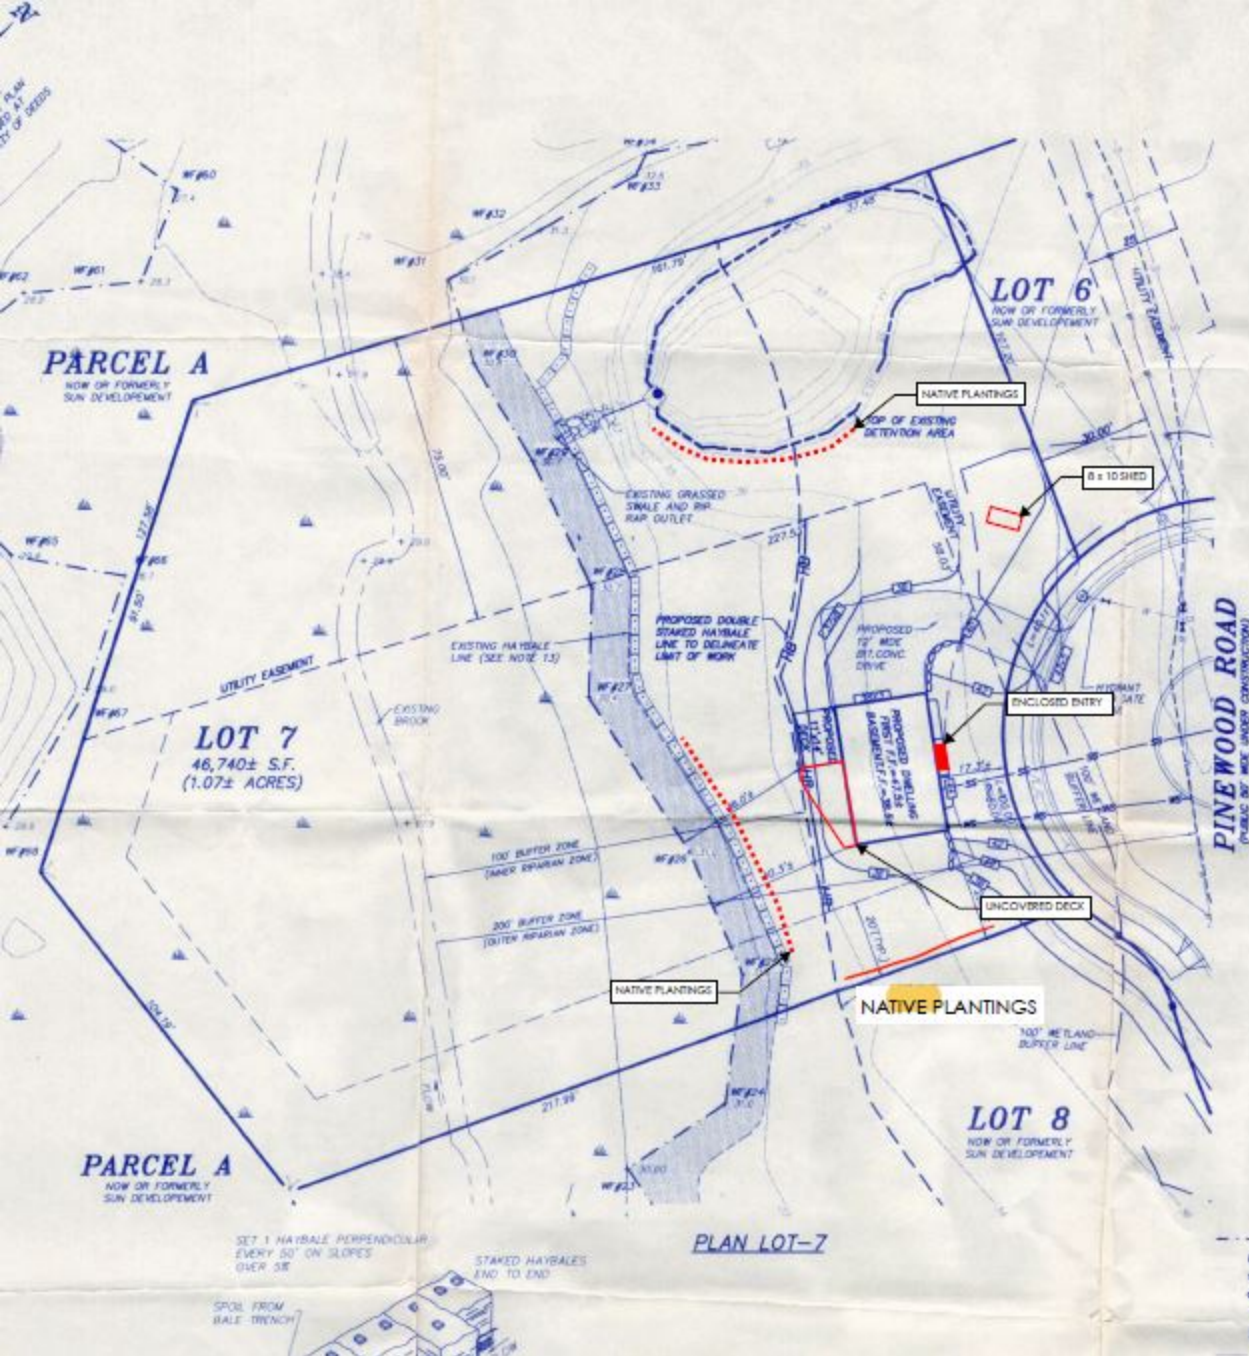

2. THE SUBJECT PROPERTY IS DEPICTED ON PLANS OF RECORD.
3. THE LOCATION OF ALL UNDERGROUND AND ARE BASED UPON A PARTIAL FIELD OF PLANS OF RECORD. MODERN ENGINEERING RECORDS MAY BE OBTAINED OR NOT DEPICTED. THE CONTRACTOR'S CONSTRUCTION SHALL VERIFY THE CONTACT DOWNSIDE AT 1-800-322-4444.
4. TOPOGRAPHICAL SITE FEATURES SHOWN WERE OBTAINED FROM A PARTIAL FIELD OF PLANS OF RECORD. MODERN ENGINEERING RECORDS MAY BE OBTAINED OR NOT DEPICTED. THE CONTRACTOR'S CONSTRUCTION SHALL VERIFY THE CONTACT DOWNSIDE AT 1-800-322-4444.
5. THE SUBJECT PROPERTY IS LOCATED AT FLOODING AS DEPICTED ON FLOOD MAPS OF RECORD. MODERN ENGINEERING RECORDS MAY BE OBTAINED OR NOT DEPICTED. THE CONTRACTOR'S CONSTRUCTION SHALL VERIFY THE CONTACT DOWNSIDE AT 1-800-322-4444.
6. ELEVATIONS REFER TO NATIONAL GEODETIC SURVEYING BENCHMARK: BROWNIE DISK ON ELEVATION 60.74 PROVIDED BY THE DEPARTMENT.
7. SALTATION BARRIERS SHALL BE STAKED OF WORK ON THE SITE (REMOVE AFTER).
8. WETLAND FLAGS WERE DEMARCATED BY AUGUST 12, 1988 AND ON JULY 11, 1988. WETLANDS WERE DEMARCATED BY AUGUST 12, 1988. FOR THE DATE.
9. THE SOLE PURPOSE OF THIS PLAN IS TO BE THIS PLAN IS NOT TO BE USED FOR CONSTRUCTION.
10. NO ROAD SALTS MAY BE USED FOR DECONTAMINATION.
11. GROUNDWATER ELEVATIONS ARE UNKNOWN. COMMENCEMENT OF CONSTRUCTION OF ELEVATION AND ADJUST FINISHED FLOOD BASEMENT ELEVATIONS.
12. ALL GRADING PROPOSED ON PARCELS A AND PARCELS A AND ALL SCREENED UP HAVE BEEN APPROVED AND INSTALLED. THE AMESBURY CONSERVATION COMMISSION.
13. PRIOR TO THE RECOMMENDATION OF A CONTRACTOR SHALL INSPECT THE EAS AREA FOR REMOVAL OF THE CONSTRUCTION FROM THE ON-SITE SUPPLIES.

EROSION CONTROL MEAS.

- A. SILT FENCE TO BE INSTALLED IN ADDITION TO THE BEGINNING OF CONSTRUCTION.
- B. ALL DISTURBED AREAS ARE TO BE COVERED WITH OTHER SUITABLE GROUND COVER UNLESS OTHERWISE SPECIFIED.
- C. SILT FENCE IS TO REMAIN IN PLACE UNTIL EROSION HAS BEEN ESTABLISHED.
- D. ALL EROSION CONTROL FENCES SHALL BE MAINTAINED AND ANY DEBRIS AND/OR SEDIMENT TO BE REMOVED.
- E. ADDITIONAL SKELETON FENCES AND/OR EROSION CONTROL FENCES SHALL BE REPLACED ANY AREAS OF FENCE DISTURBED BY CONSTRUCTION.
- F. ALL STOCKPILING OF MATERIALS OR EQUIPMENT SHALL BE STABILIZED WITHIN 14 (14) DAYS.

LEGEND:

---	EDGE OF WETLANDS	85
HF#3	WETLAND FLAG	□ □ □ □ □ □
③	EXISTING WATER SERVICE	SS
③	EXISTING WATER GATE	WS
③	EXISTING GAS GATE	WAG
★	PROPOSED LIGHT	
—	EXISTING WATER LINE	W