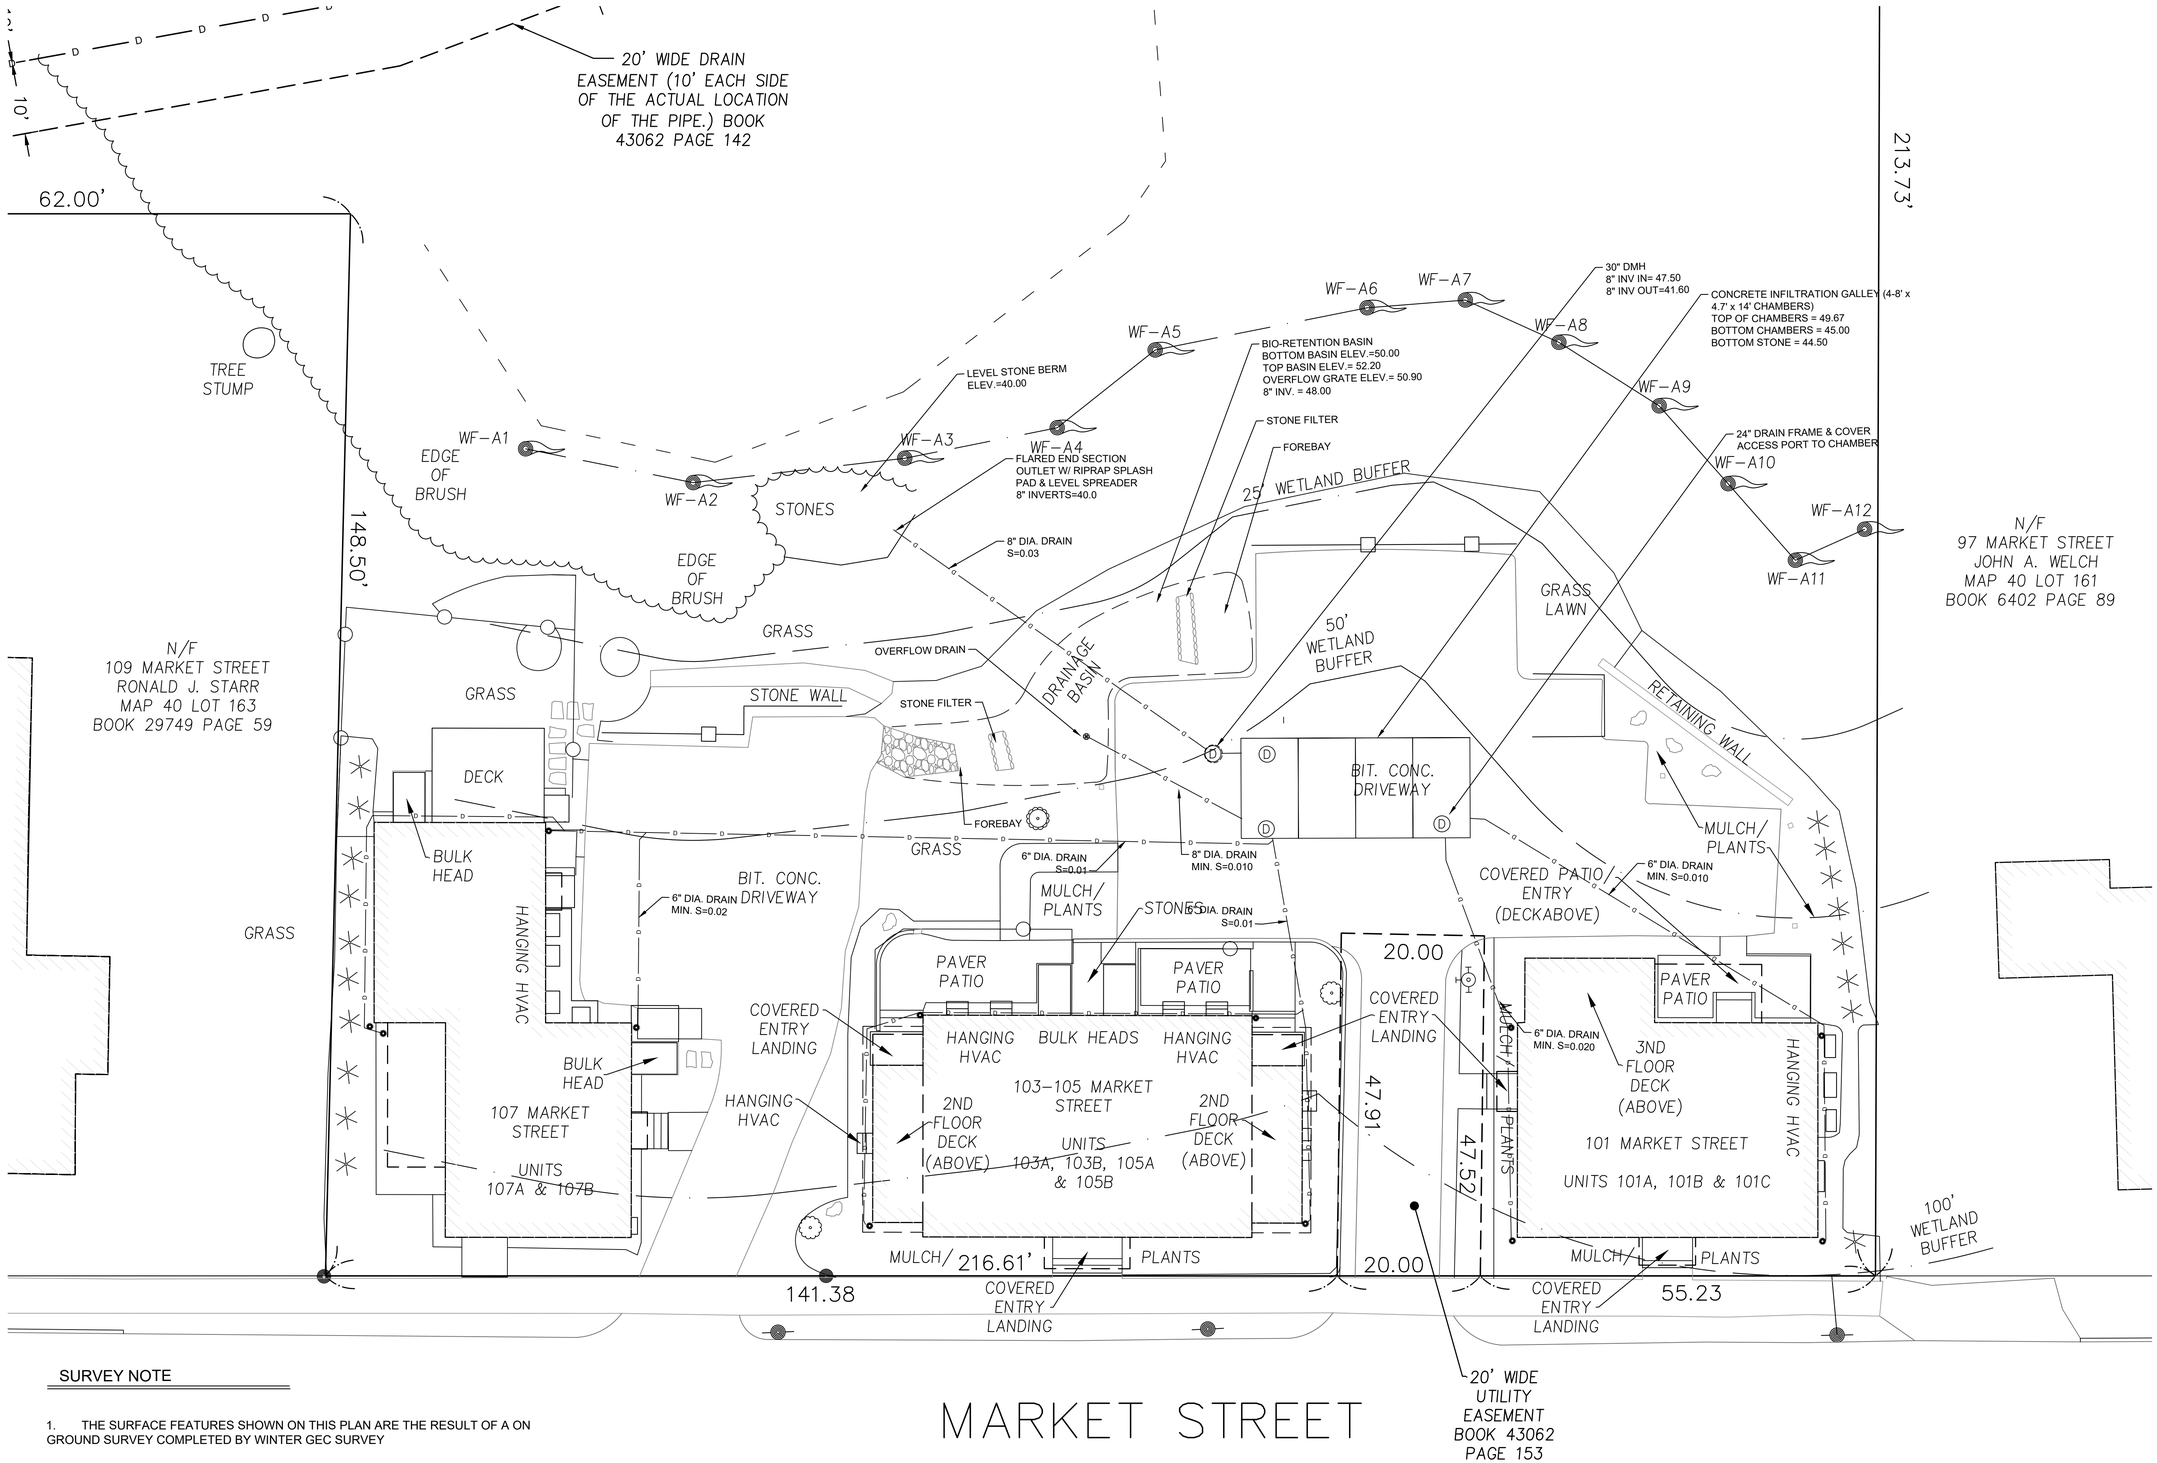

SURVEY NOTE

1. THE SURFACE FEATURES SHOWN ON THIS PLAN ARE THE RESULT OF A ON GROUND SURVEY COMPLETED BY WINTER GEC SURVEY

0 10 20 30 40

SCALE: 1" = 10'

NORTH

OWNER
NEWBURYPORT HOMES LLC
11 LUNT STREET
BYFIELD, MA 01951

ENGINEER
SBS ENGINEERING
15 COLLINS STREET
NEWBURYPORT, MA 01950

SURVEYOR
WINTER GEC
44 MERRIMAC STREET
NEWBURYPORT, MA 01950

ARCHITECT
GRAF DESIGN ASSOC.
2 LIBERTY STREET
NEWBURYPORT, MA 01950

PROJECT TEAM

PROJECT NAME

101-107 MARKET ST.
AMESBURY, MA

PROJECT INFO

REV	DESCRIPTION	DATE

STAMP: COMMONWEALTH OF MASSACHUSETTS — STEPHEN B. SAWYER — CIVIL — No. 54025 — REGISTERED PROFESSIONAL ENGINEER

SHEET NAME: SITE AS-BUILT PLAN

SHT NO: AB-1

DR BY:	SBS
CHK BY:	SBS
PROJ NO:	101 MARKET ST
DATE:	6/24/2026
SCALE:	1" = 10'