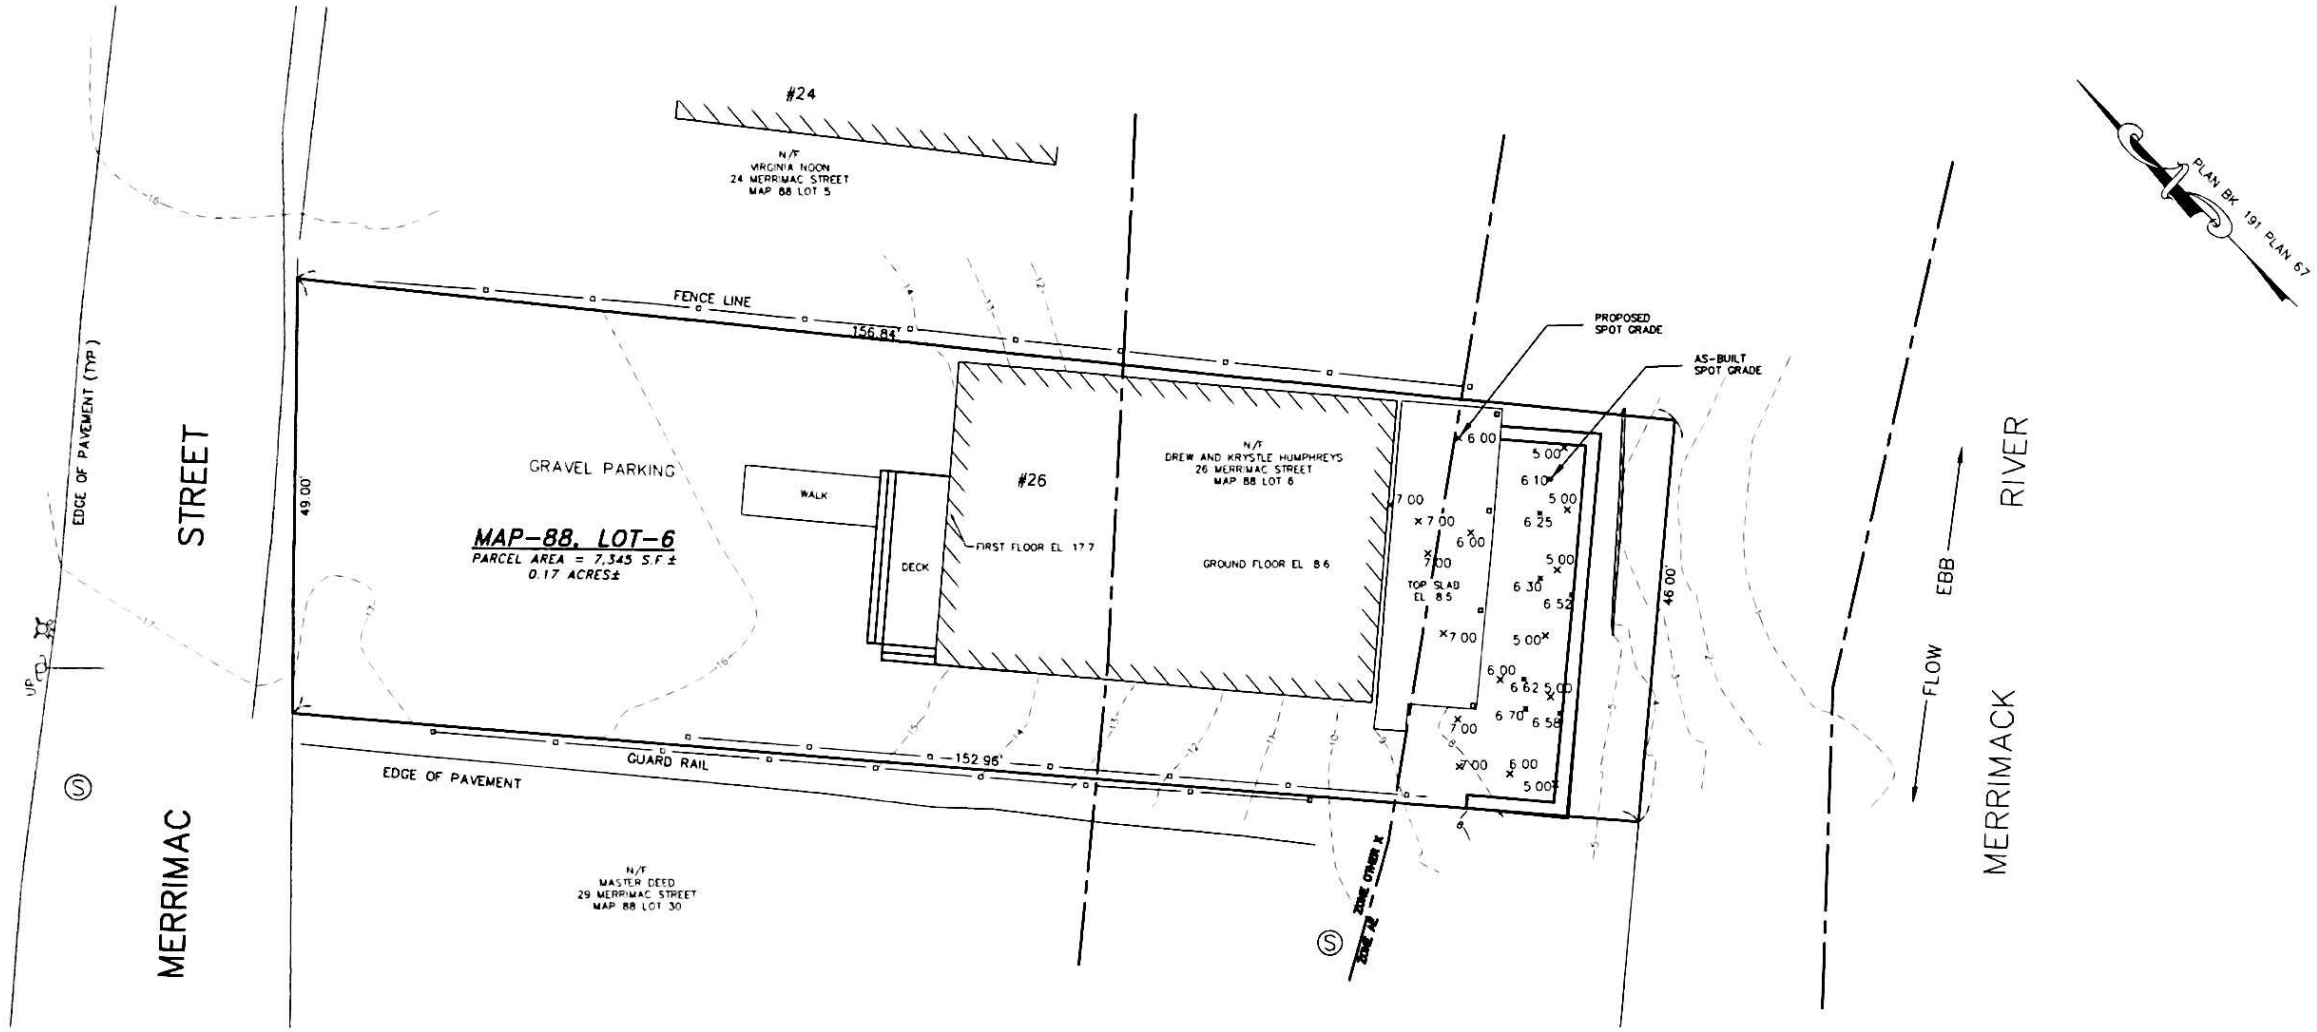

AS-BUILT SITE PLAN

SCALE: 1"=10'

LEGEND

—W—	WATER MAIN
● WG	WATER GATE
	HYDRANT
—G—	GAS MAIN
● GG	GAS GATE
—SS—	SAN. SEWEER MAIN
Ⓢ	SEWER MANHOLE
—D—	STORM DRAIN
Ⓓ	DRAIN MANHOLE
▦	CATCH BASIN
	UTILITY POLE
—OHW—	OVERHEAD WIRE
—•—•—	CHAIN LINK FENCE
—•—•—	STOCKADE FENCE
DYL	DOUBLE YELLOW LINE
PWL	PAINTED WHITE LINE
⊗ WF	WETLAND FLAG
59	EXISTING CONTOUR
× 6.52	AS-BUILT SPOT GRADE
× 5.00	PROPOSED SPOT GRADE

GRAPHIC SCALE

(IN FEET)
1 inch = 10 ft.

JOHN W. HARGREAVES, PE/PLS

7/3/26

DATE: 7.3.2026

REVISIONS:

SHEET 1 OF 1

AS-BUILT SITE PLAN
ASSESSOR'S MAP 88, LOT 6
26 MERRIMAC STREET
AMESBURY, MASSACHUSETTS

OWNER AND APPLICANT:
DREW & KRYSTLE HUMPHREYS
26 MERRIMAC STREET
AMESBURY, MA 01913

GA CONSULTANTS, INC.
10 STATE STREET, NEWBURYPORT, MA 01950

PROFESSIONAL ENGINEERS & LAND SURVEYORS
TEL 978-502-5197